

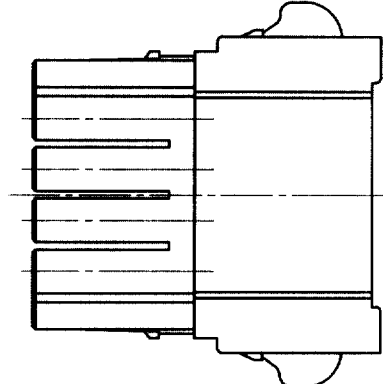
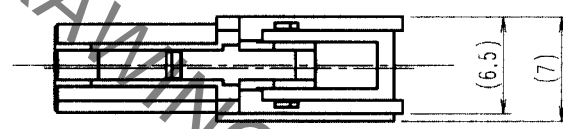


	COUNT	DESCRIPTION OF REVISIONS	BY	CHKD	DATE	COUNT	DESCRIPTION OF REVISIONS	BY	CHKD	DATE
①	2	RE-E-06362	N.N.	S.M	99.6.21	△				.
②	4	RE-E-06478	N.N.	S.H	99.8.24	△				.
△					.	△				.

CONTACT CODE	APPLICABLE WIRE	RATED VOLTAGE
PX50-SC- <del>3</del> 1 ( <del>※</del> 印→1 LOOSE PIECE)	AWG # 16	10A
( <del>※</del> 印→2 STRIP)	AWG # 18	8A

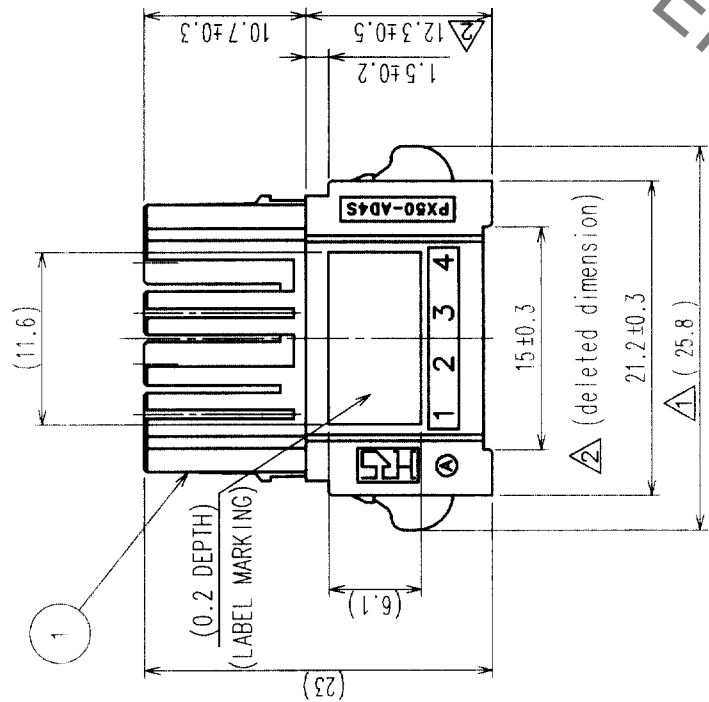

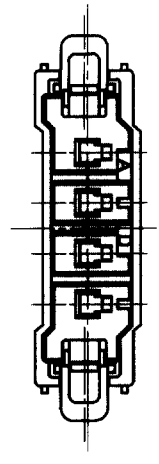

(revised configuration)  $\triangle 2$

NOTES 1 APPLICABLE CONTACT, APPLICABLE WIRE AND RATED VOLTAGE IS SHOWN IN TABLE 1.  
SPECIFIED CURRENTS ARE RATED VALUE PER CONTACT.  
(40A PER 4 CONTACTS FOR AWG#16 WIRE)

2 .NOT FOR INTERRUPTING CURRENT.

2 3 .ORDER TO BE MADE PER 100PCS.

		DRAWING NO.		PART NO.	
SCALE		EDC3-12148		PX50-AD4S	
2 : 1				CL236-0006-3	
UNITS					
mm		HIROSE ELECTRIC CO., LTD		CODE NO.	
				1	
				1	

NO.	MATERIAL	FINISH, REMARKS	1	PBT	(BLACK) UL94V-0
CODE NO. (OLD)			NO.	MATERIAL	FINISH, REMARKS
CL					
			DRAWN	DESIGNED	CHECKED
			M. Kenjo	M. Kenjo	S. Matsuzaki
			99.5.15	99.5.15	99.5.15

TO	Q1			
----	----	--	--	--